



**NORTH**  
**FIRST FLOOR AS-BUILT**  
**CANWOOD BUSINESS PARK**  
**5126 CLARETON DRIVE #110 / #140**


SCALE: NTS

NOVEMBER 26, 2007

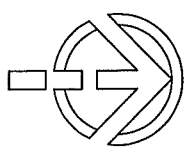

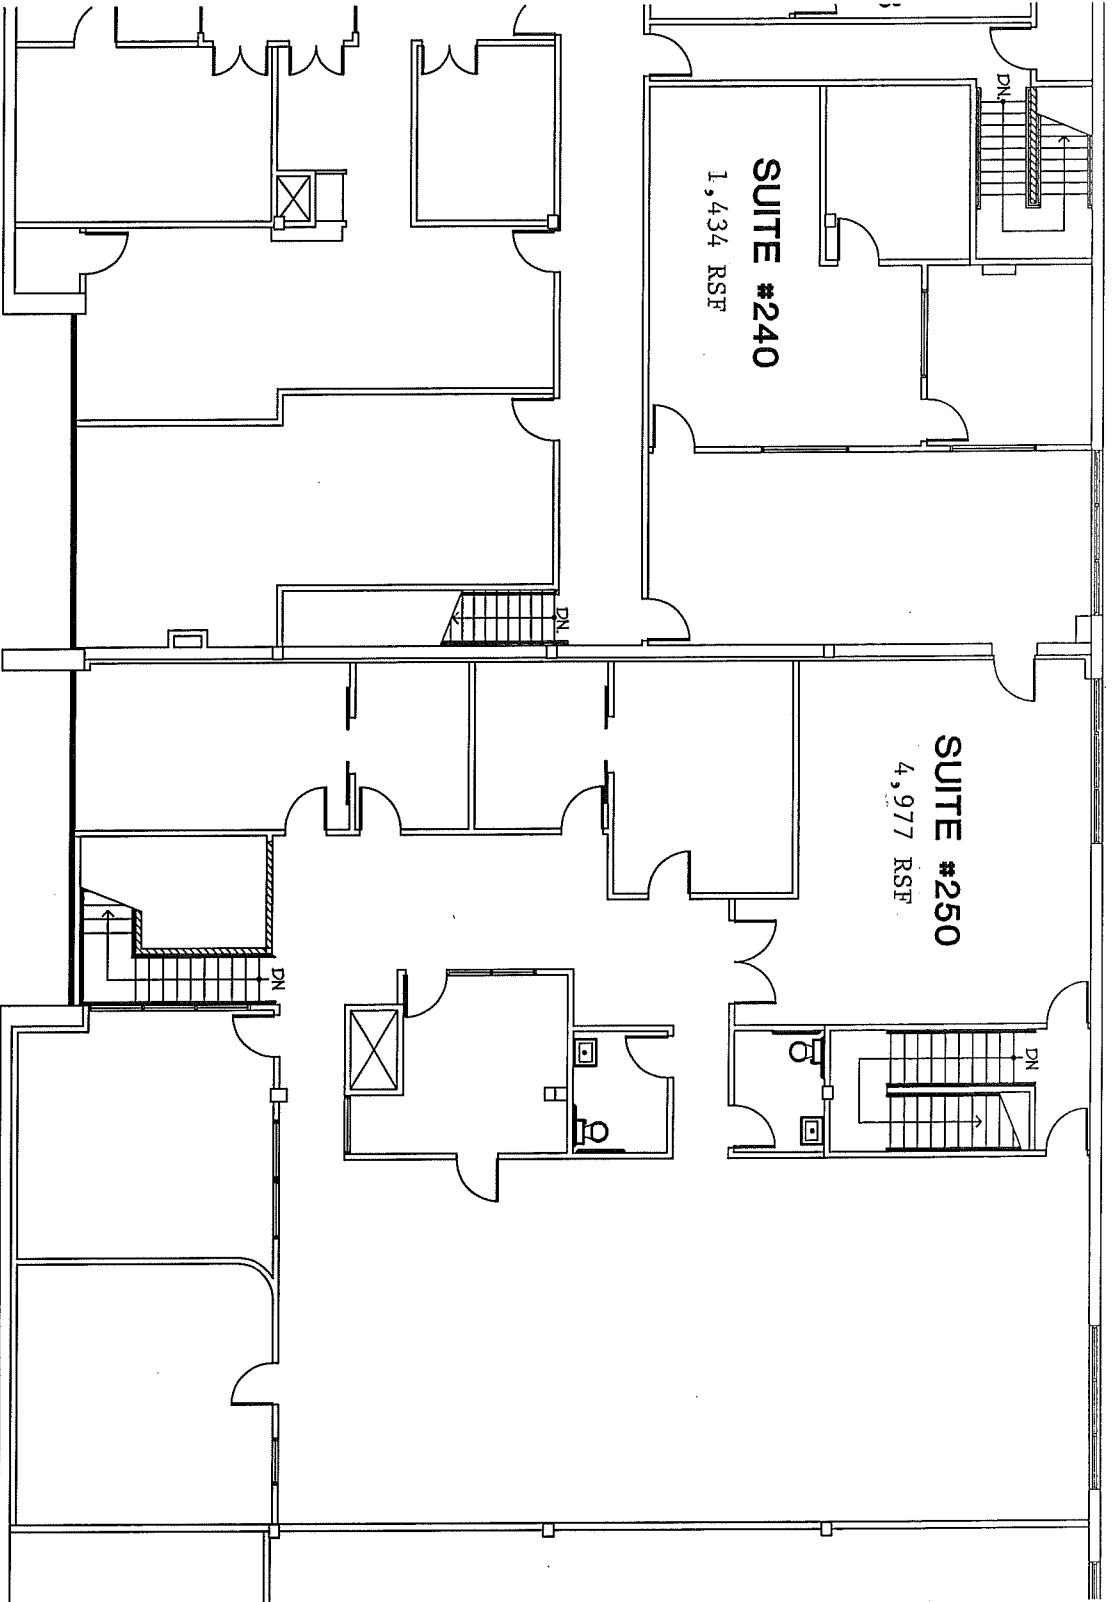

**NORTH**  
**SECOND FLOOR AS-BUILT**  
**CANWOOD BUSINESS PARK**  
**5126 CLARETON DRIVE #240/#250**

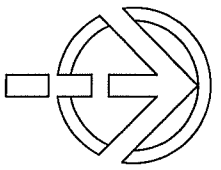

SCALE: NTS

NOVEMBER 26, 2007