



SUITE #250

±1,716 R.S.F.

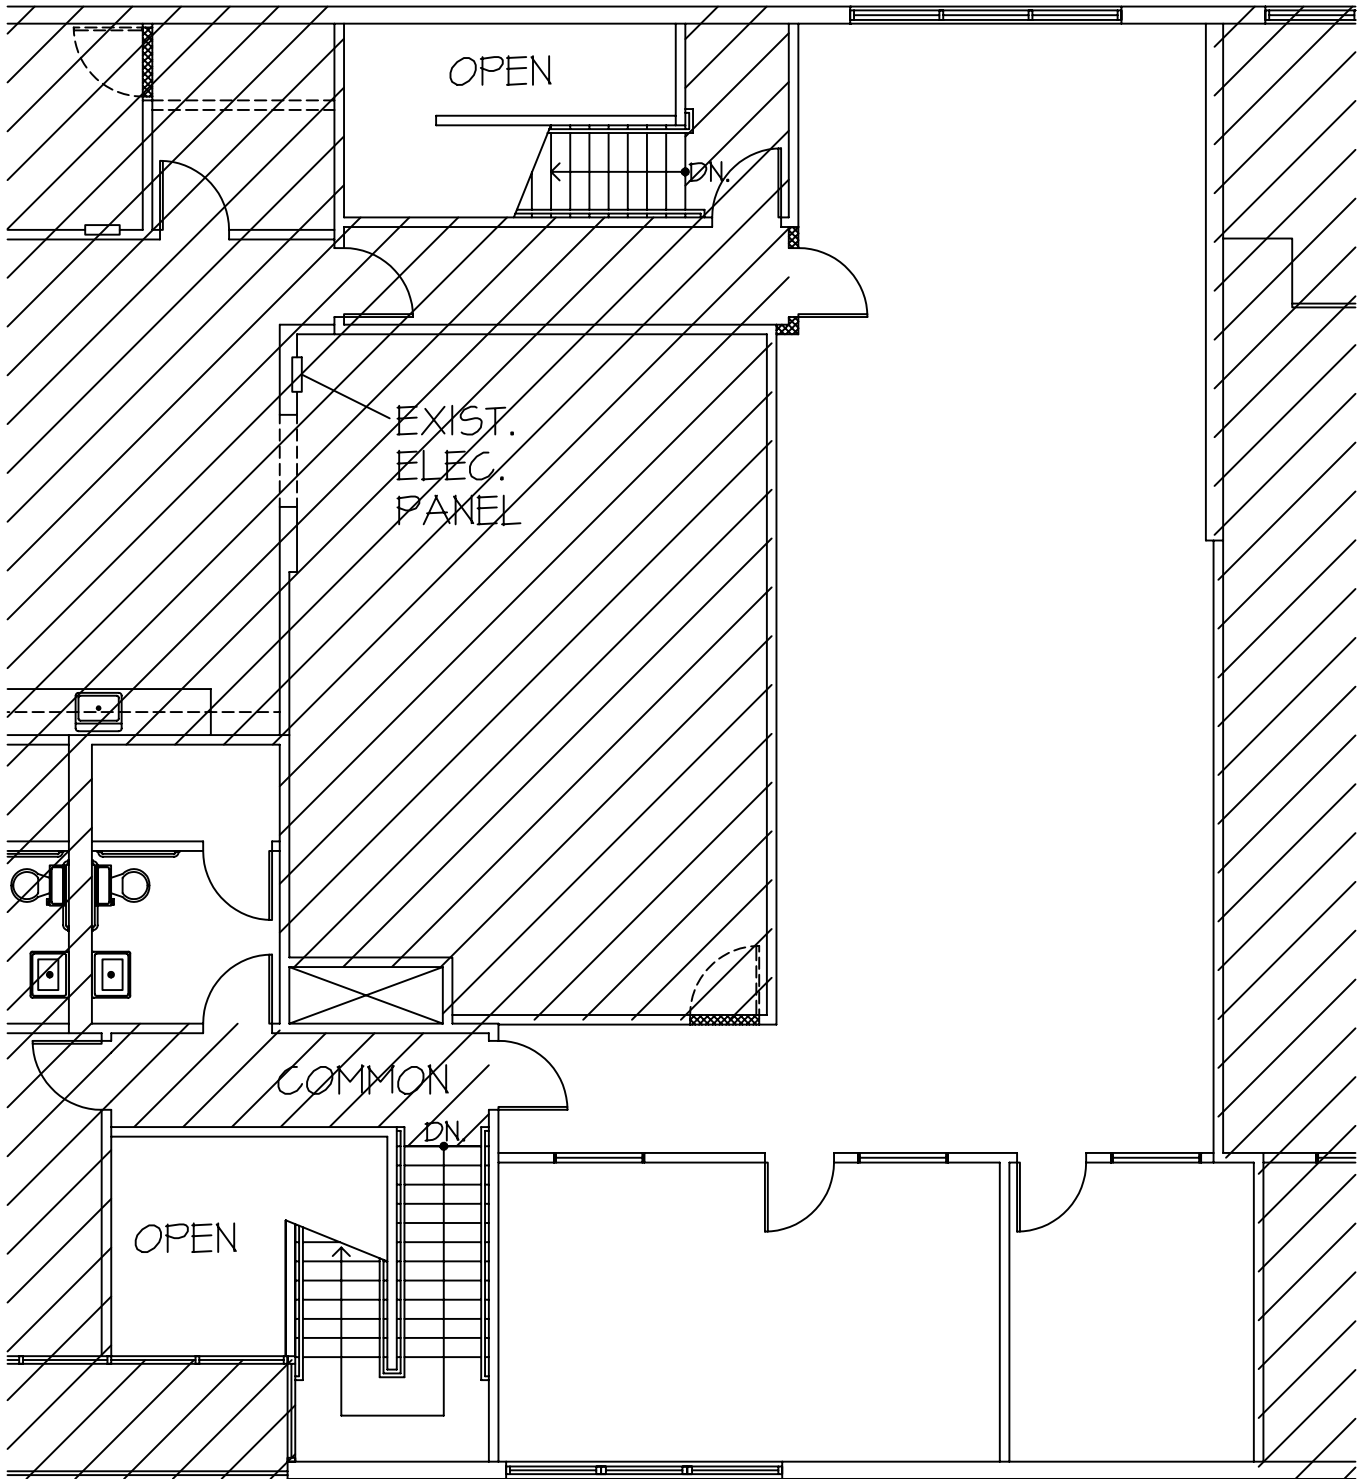

NORTH

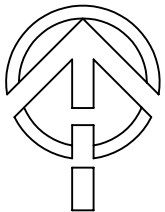

**#250 AS-BUILT
CANWOOD BUSINESS PARK
5142 CLARETON DRIVE**

SCALE: NTS

MAY 24, 2006