
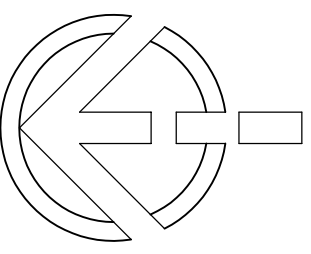


SUITE 240
±734 R.S.F.

100 E. T.O. BLVD. #240
AS-BUILT

SCALE: NTS

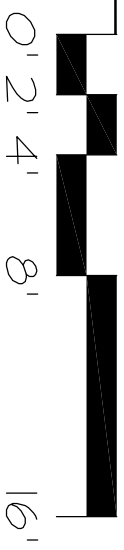

NORTH