
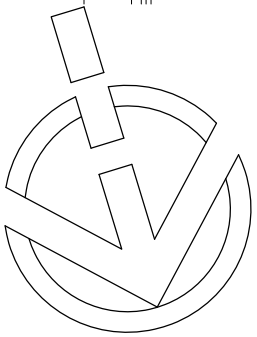


SUITE #202

±85 | R.S.F.

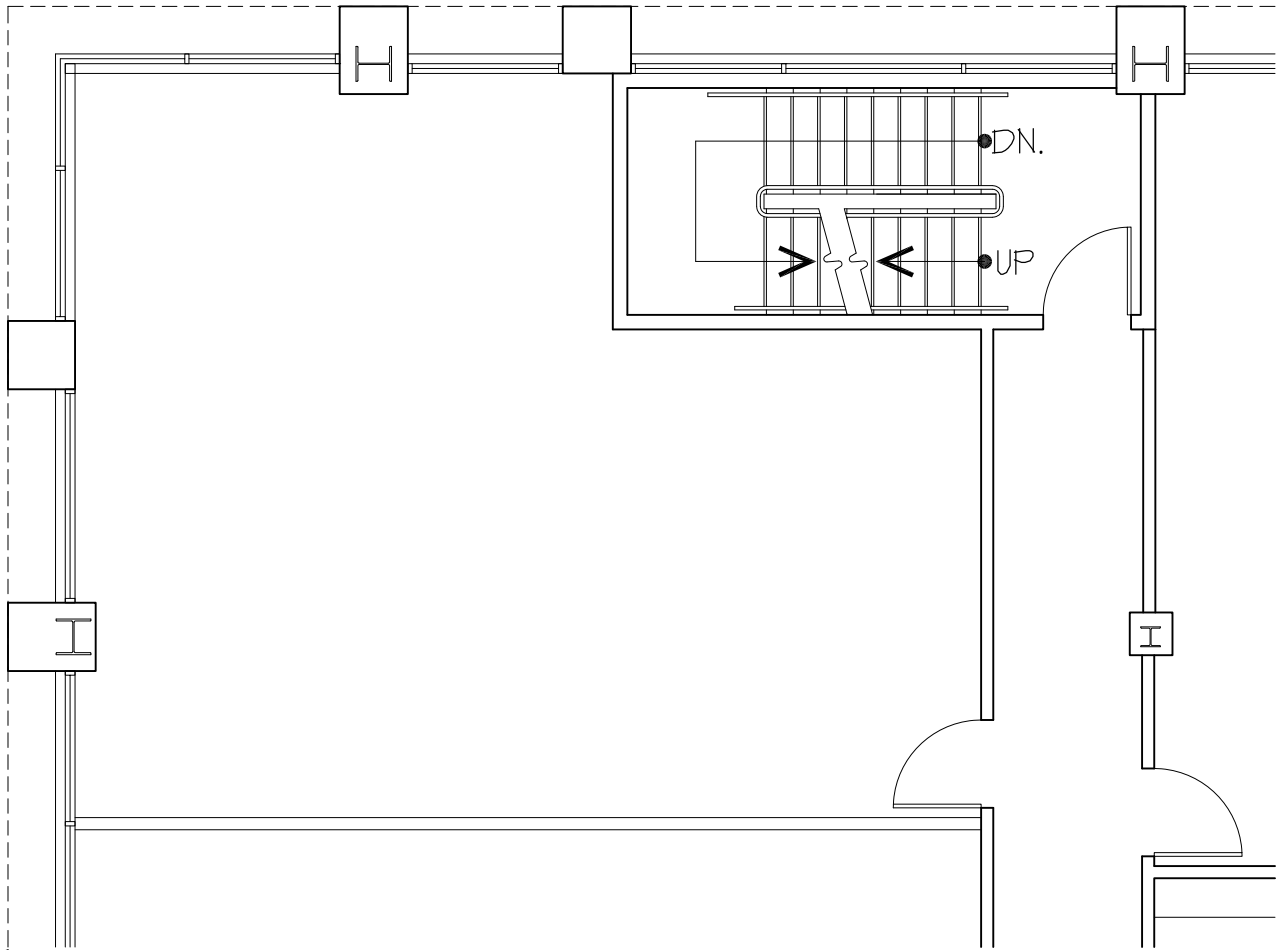

NORTH

SUITE #202 90 E. T.O. BLVD. AS-BUILT PLAN

SCALE: NTS

JANUARY 09, 2012

