



SUITE 288
±1,001 R.S.F.

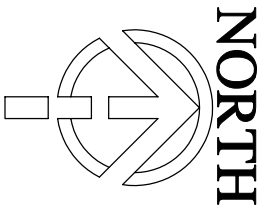


100 E. THOUSAND OAKS BLVD.
SUITE 288 AS-BUILT PLAN

SCALE: NTS

MARCH 29, 2005

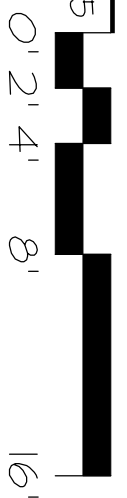

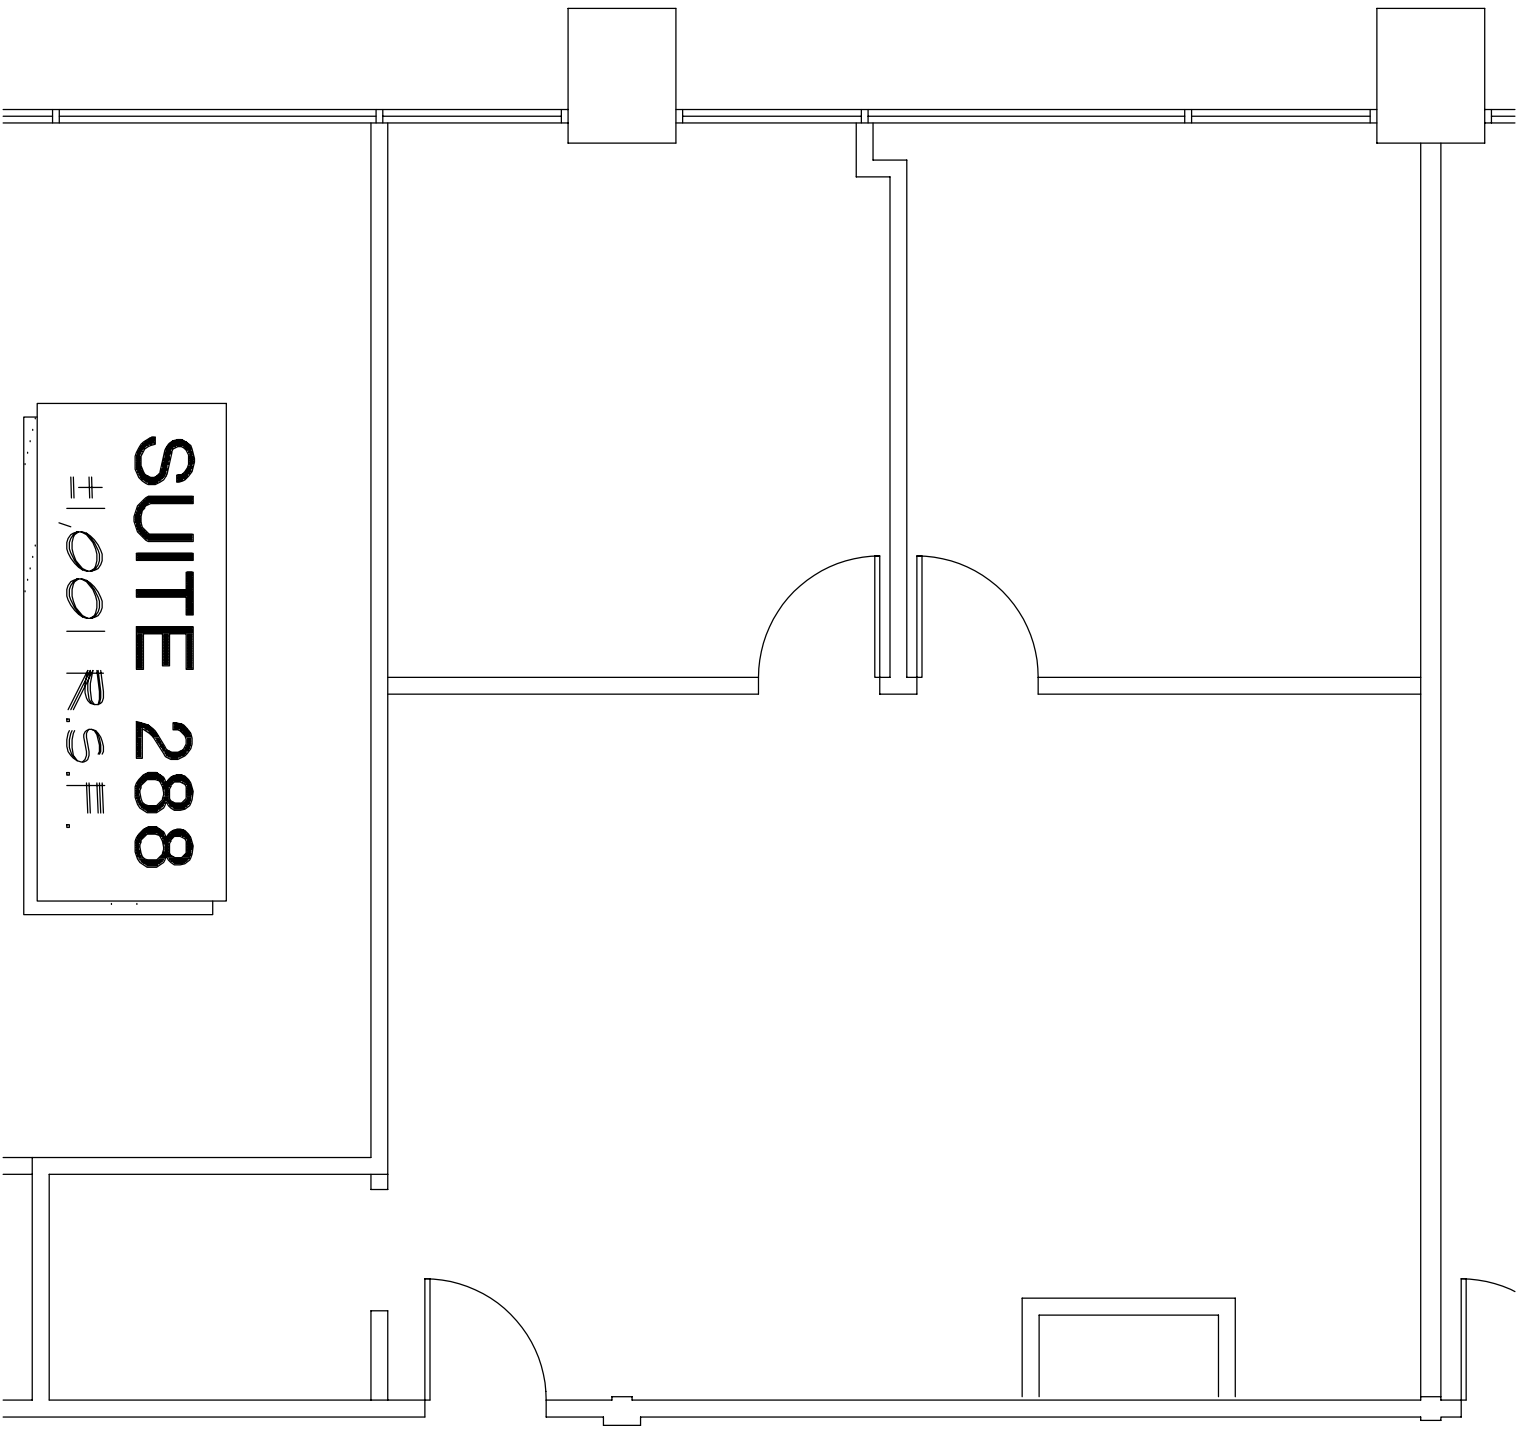

SUITE 288
±1,001 R.S.F.

100 E. THOUSAND OAKS BLVD.

SCALE: NTS

MARCH 29, 2005